




BSF Rooms 1227 & 1325 Scale: 1"=4'

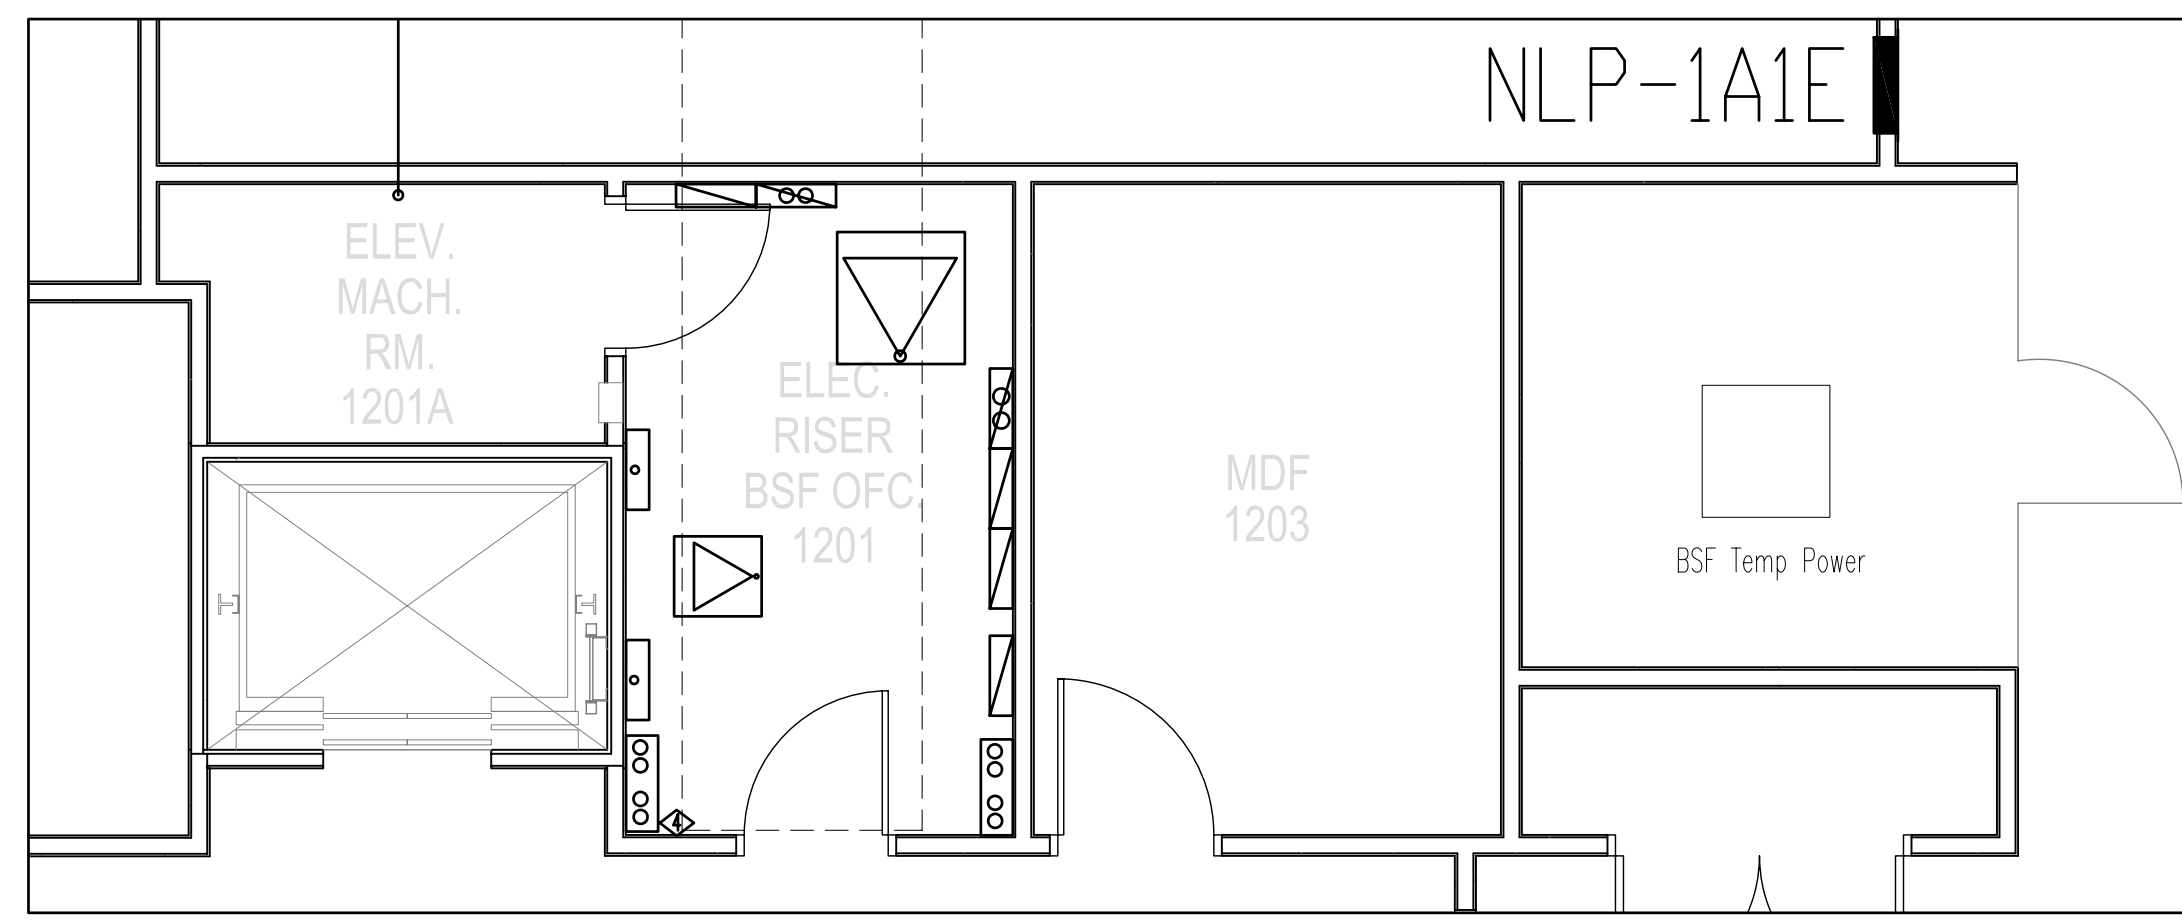



BSF Rooms 1201 & 1203 Scale: 1"=4'

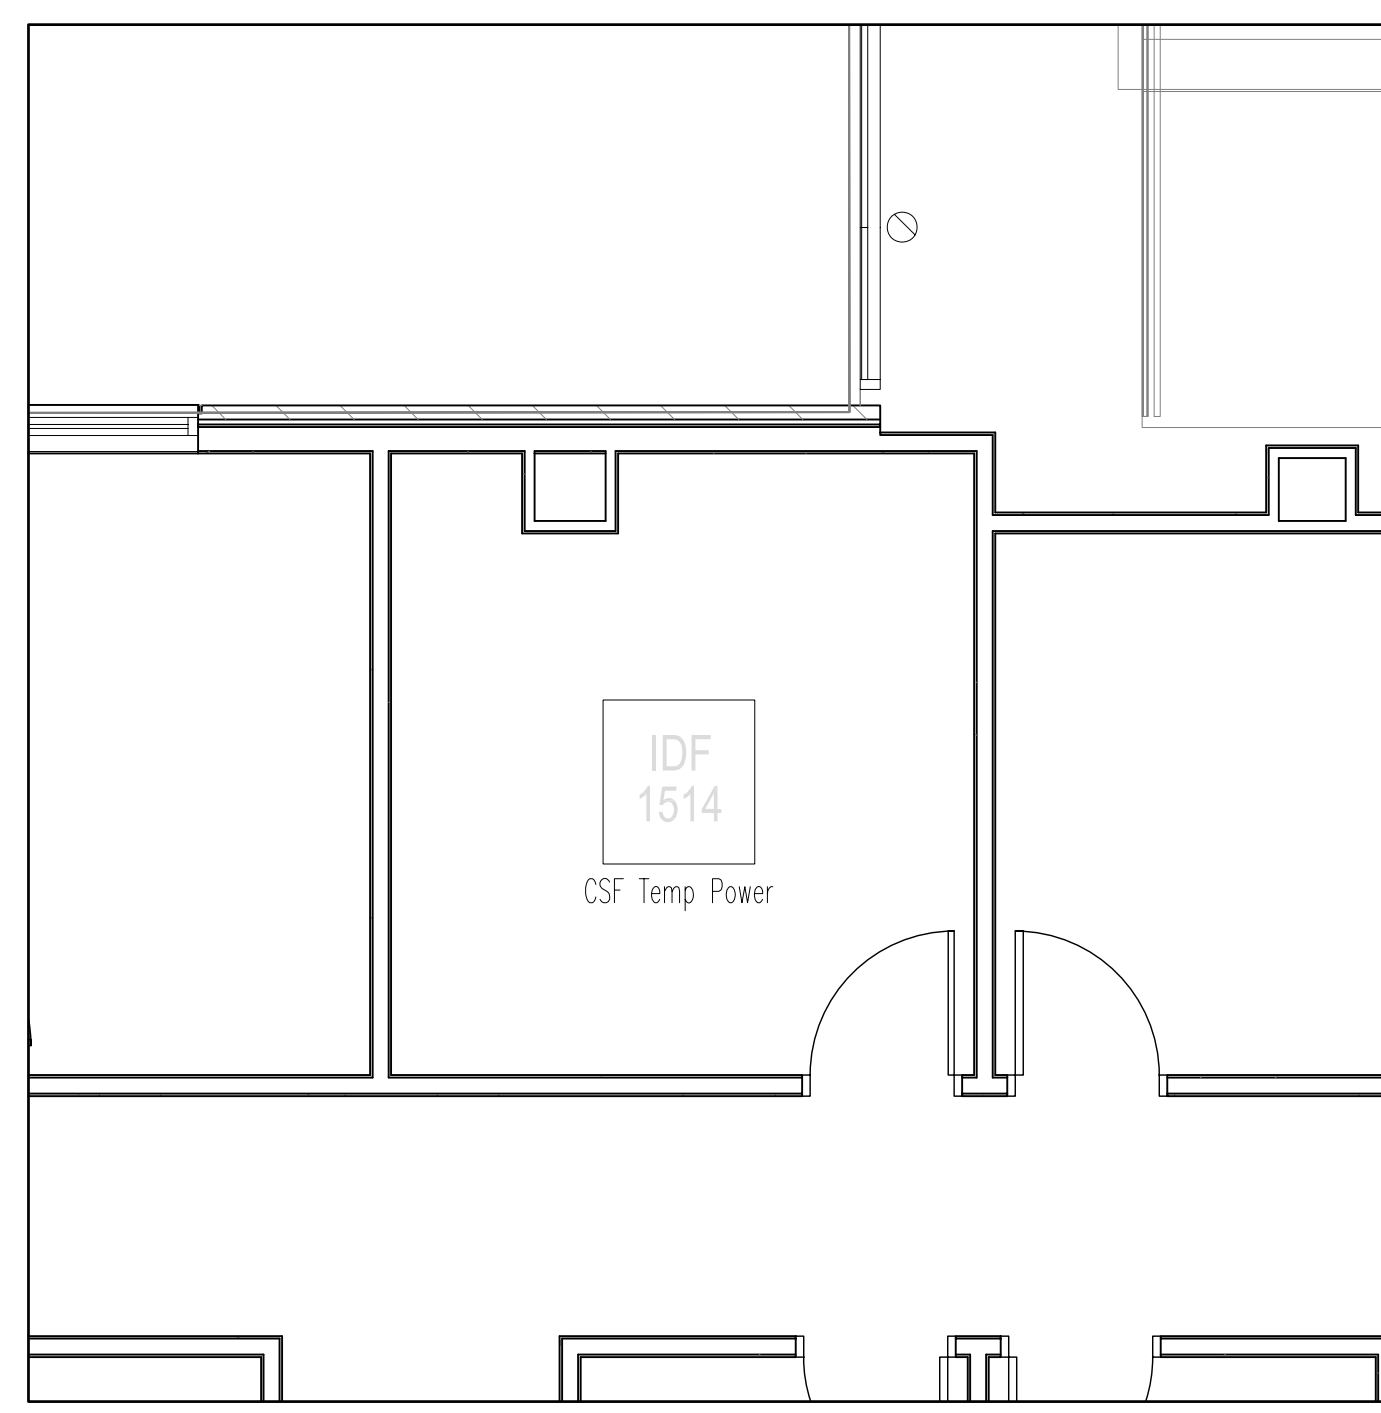


IDF Room 1514 Scale: 1"=4'

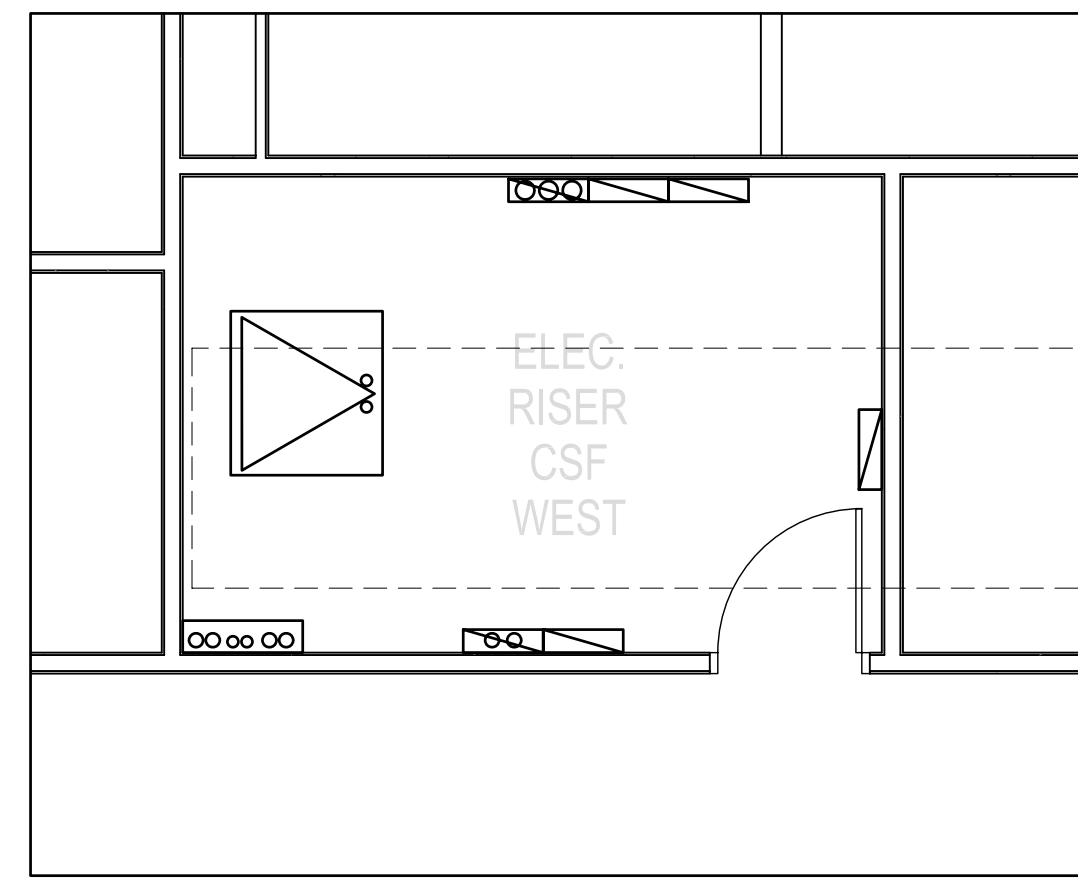


CSF Room 1731 Scale: 1"=4'

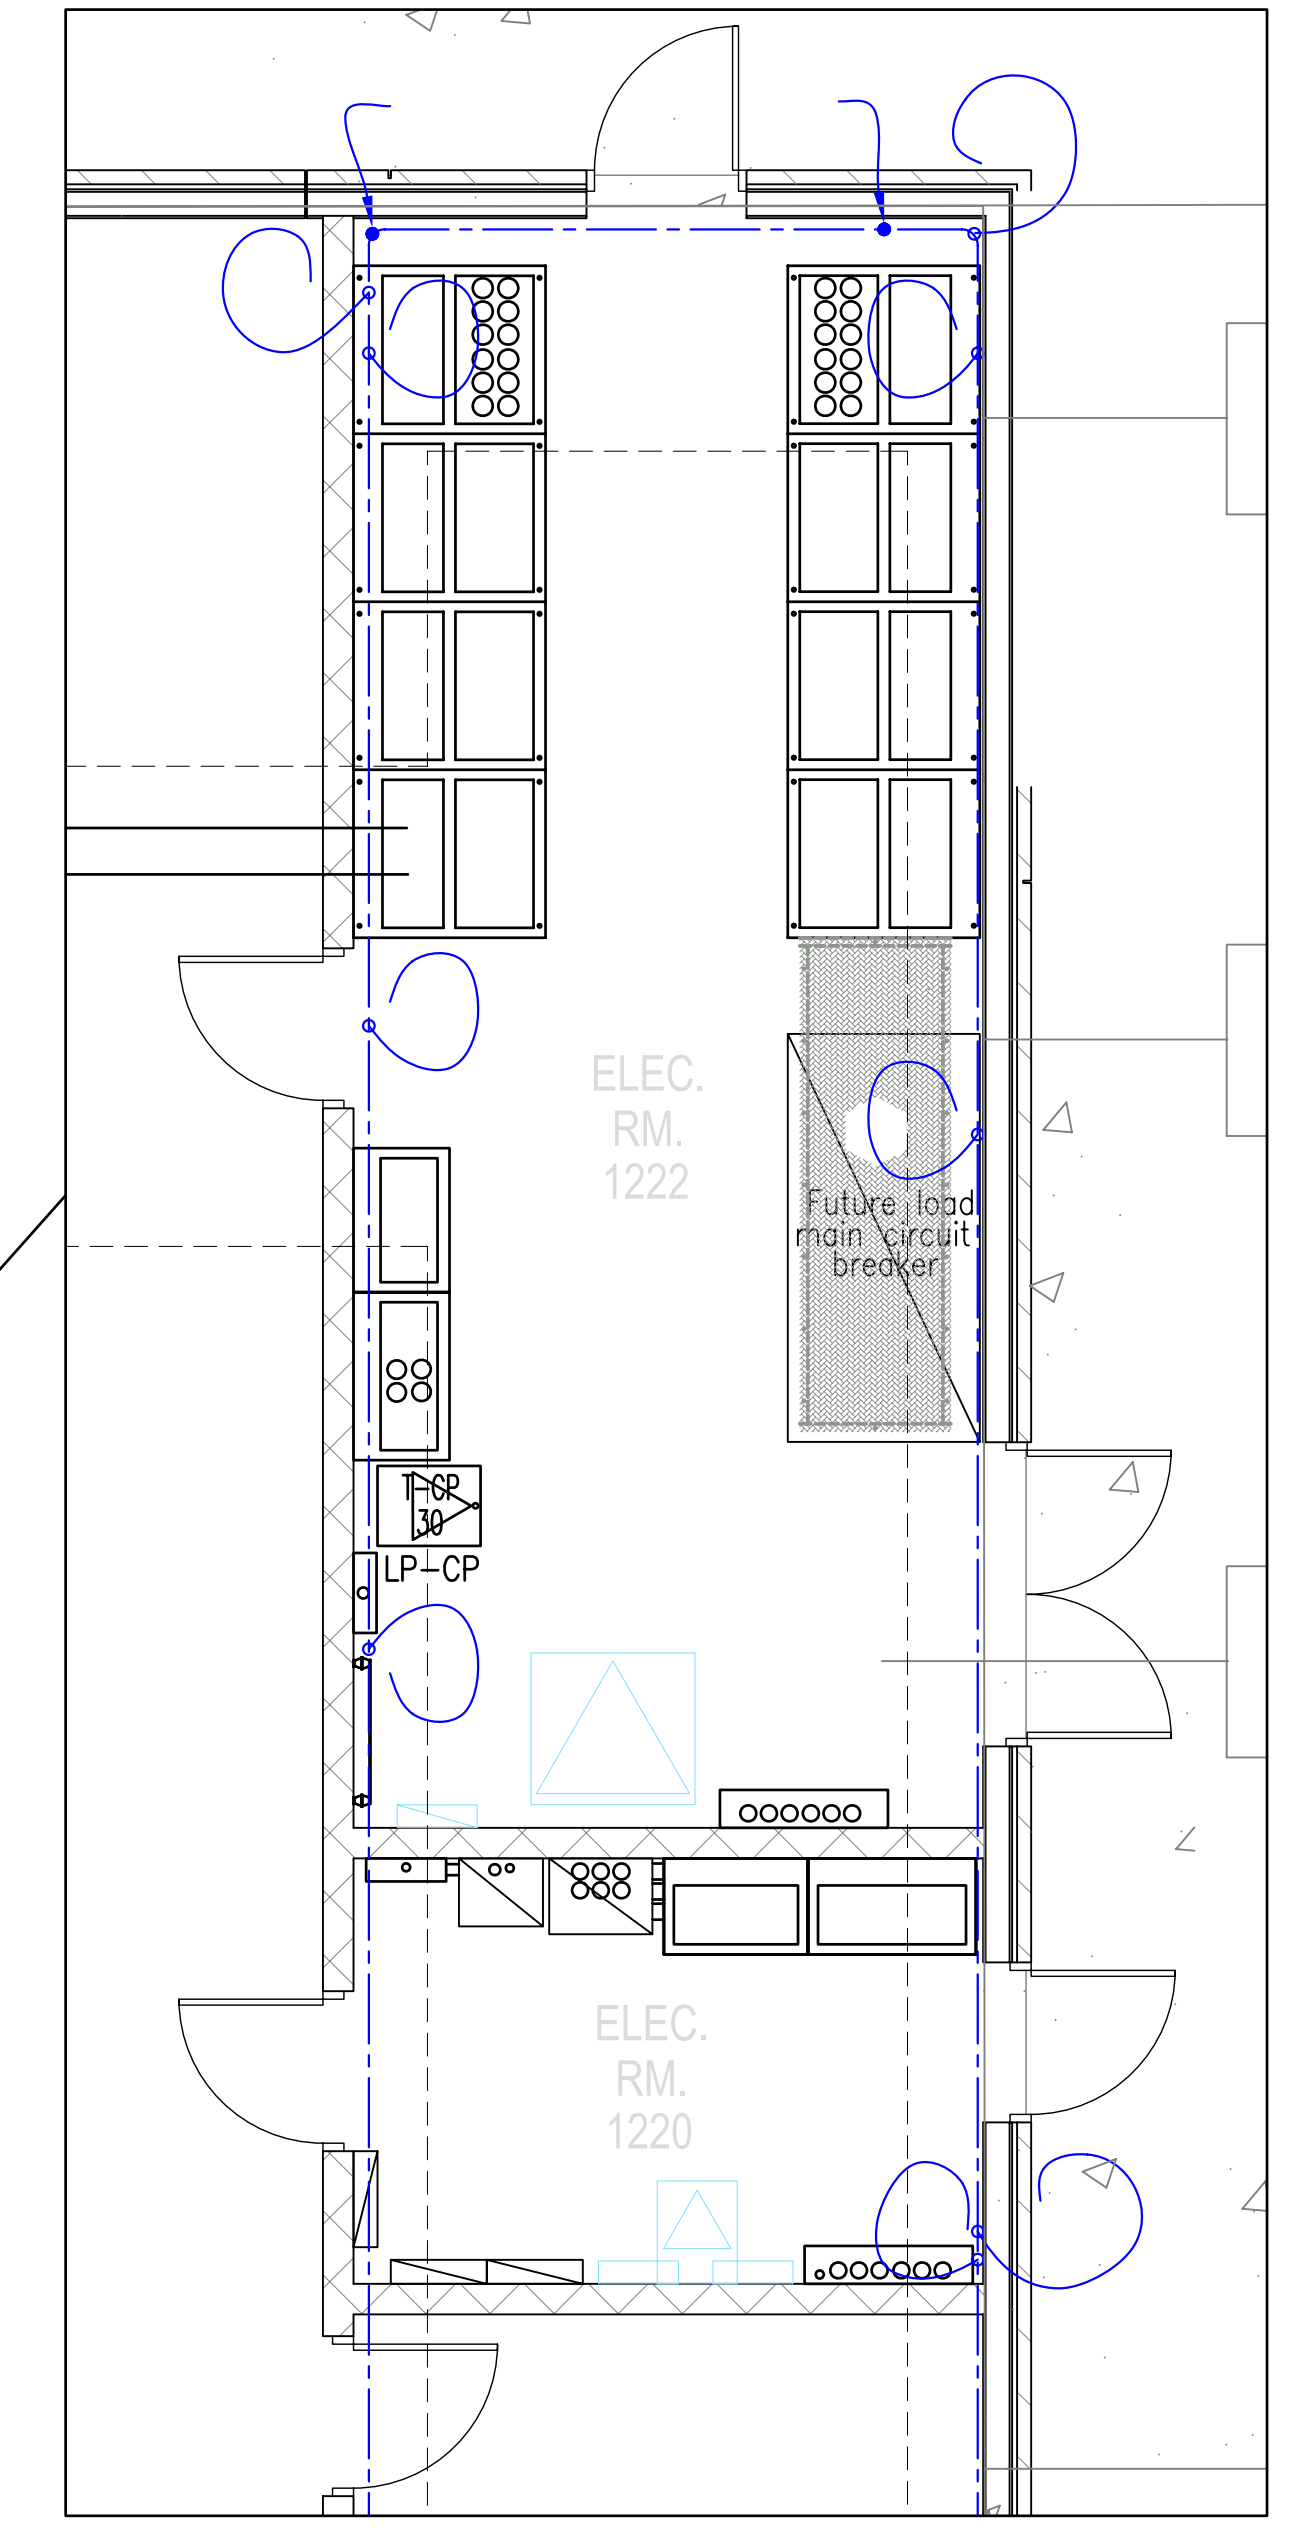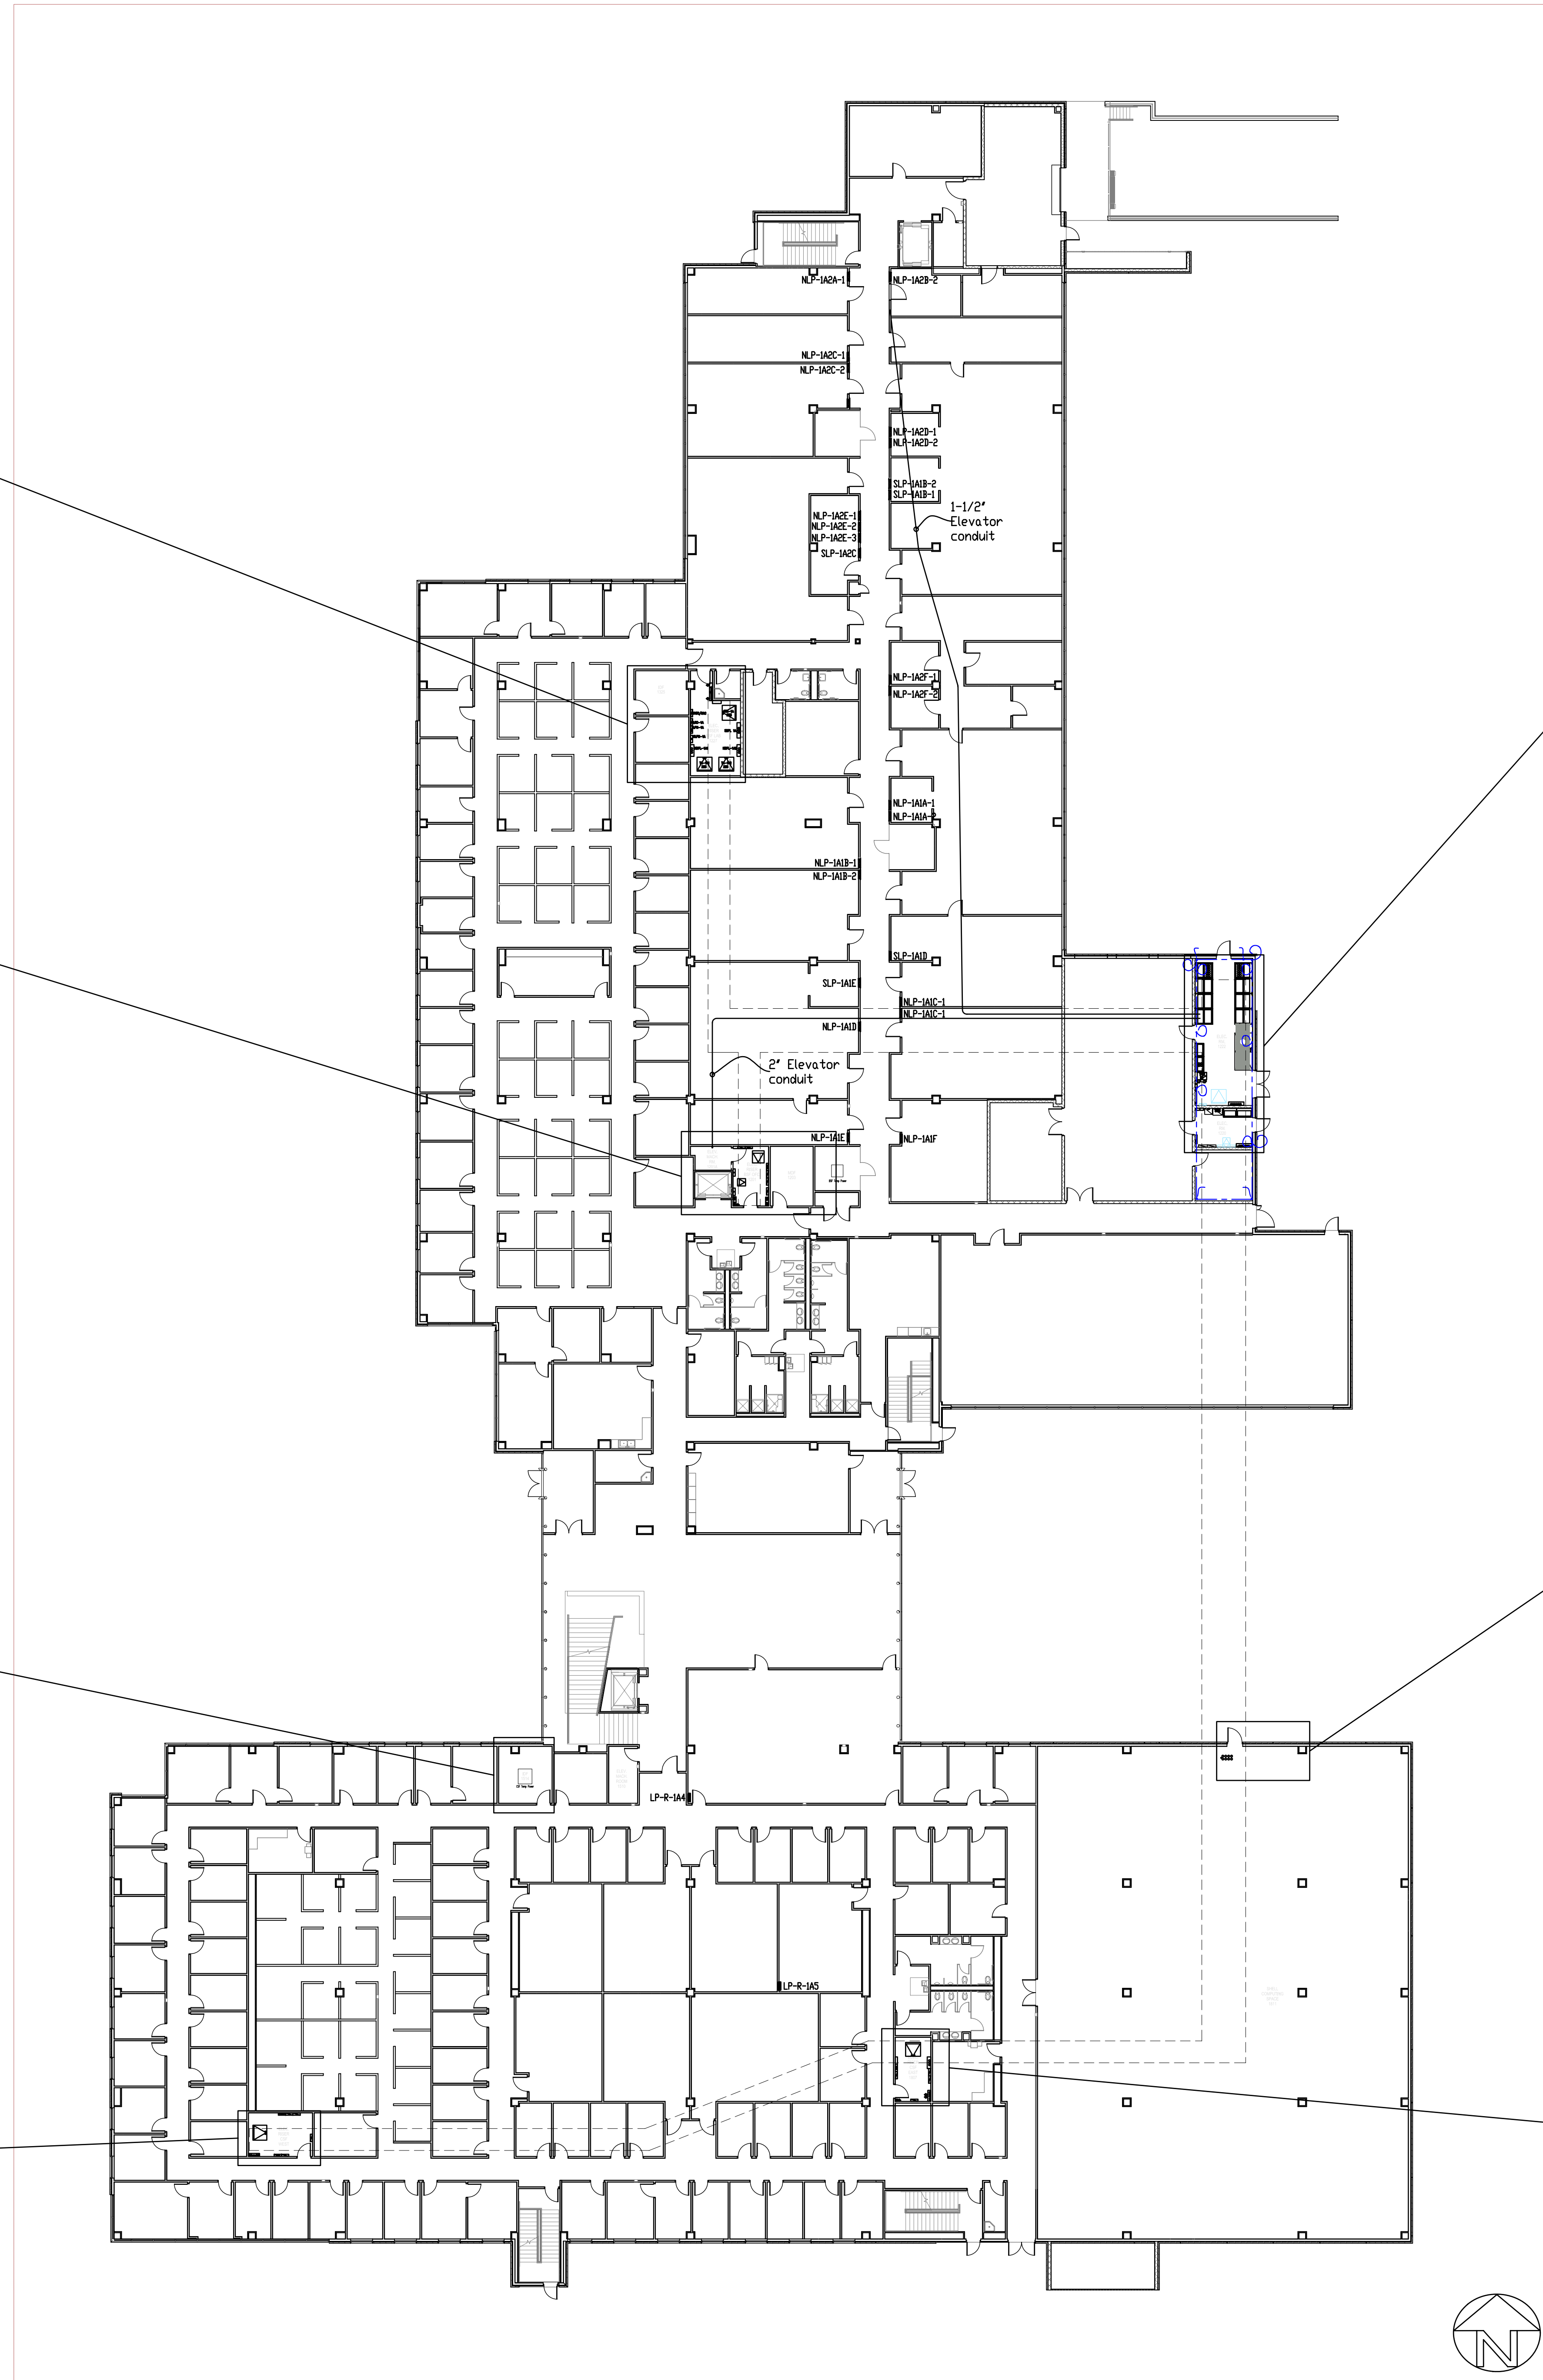

BSF Rooms 1220 & 1222 Scale: 1"=4'

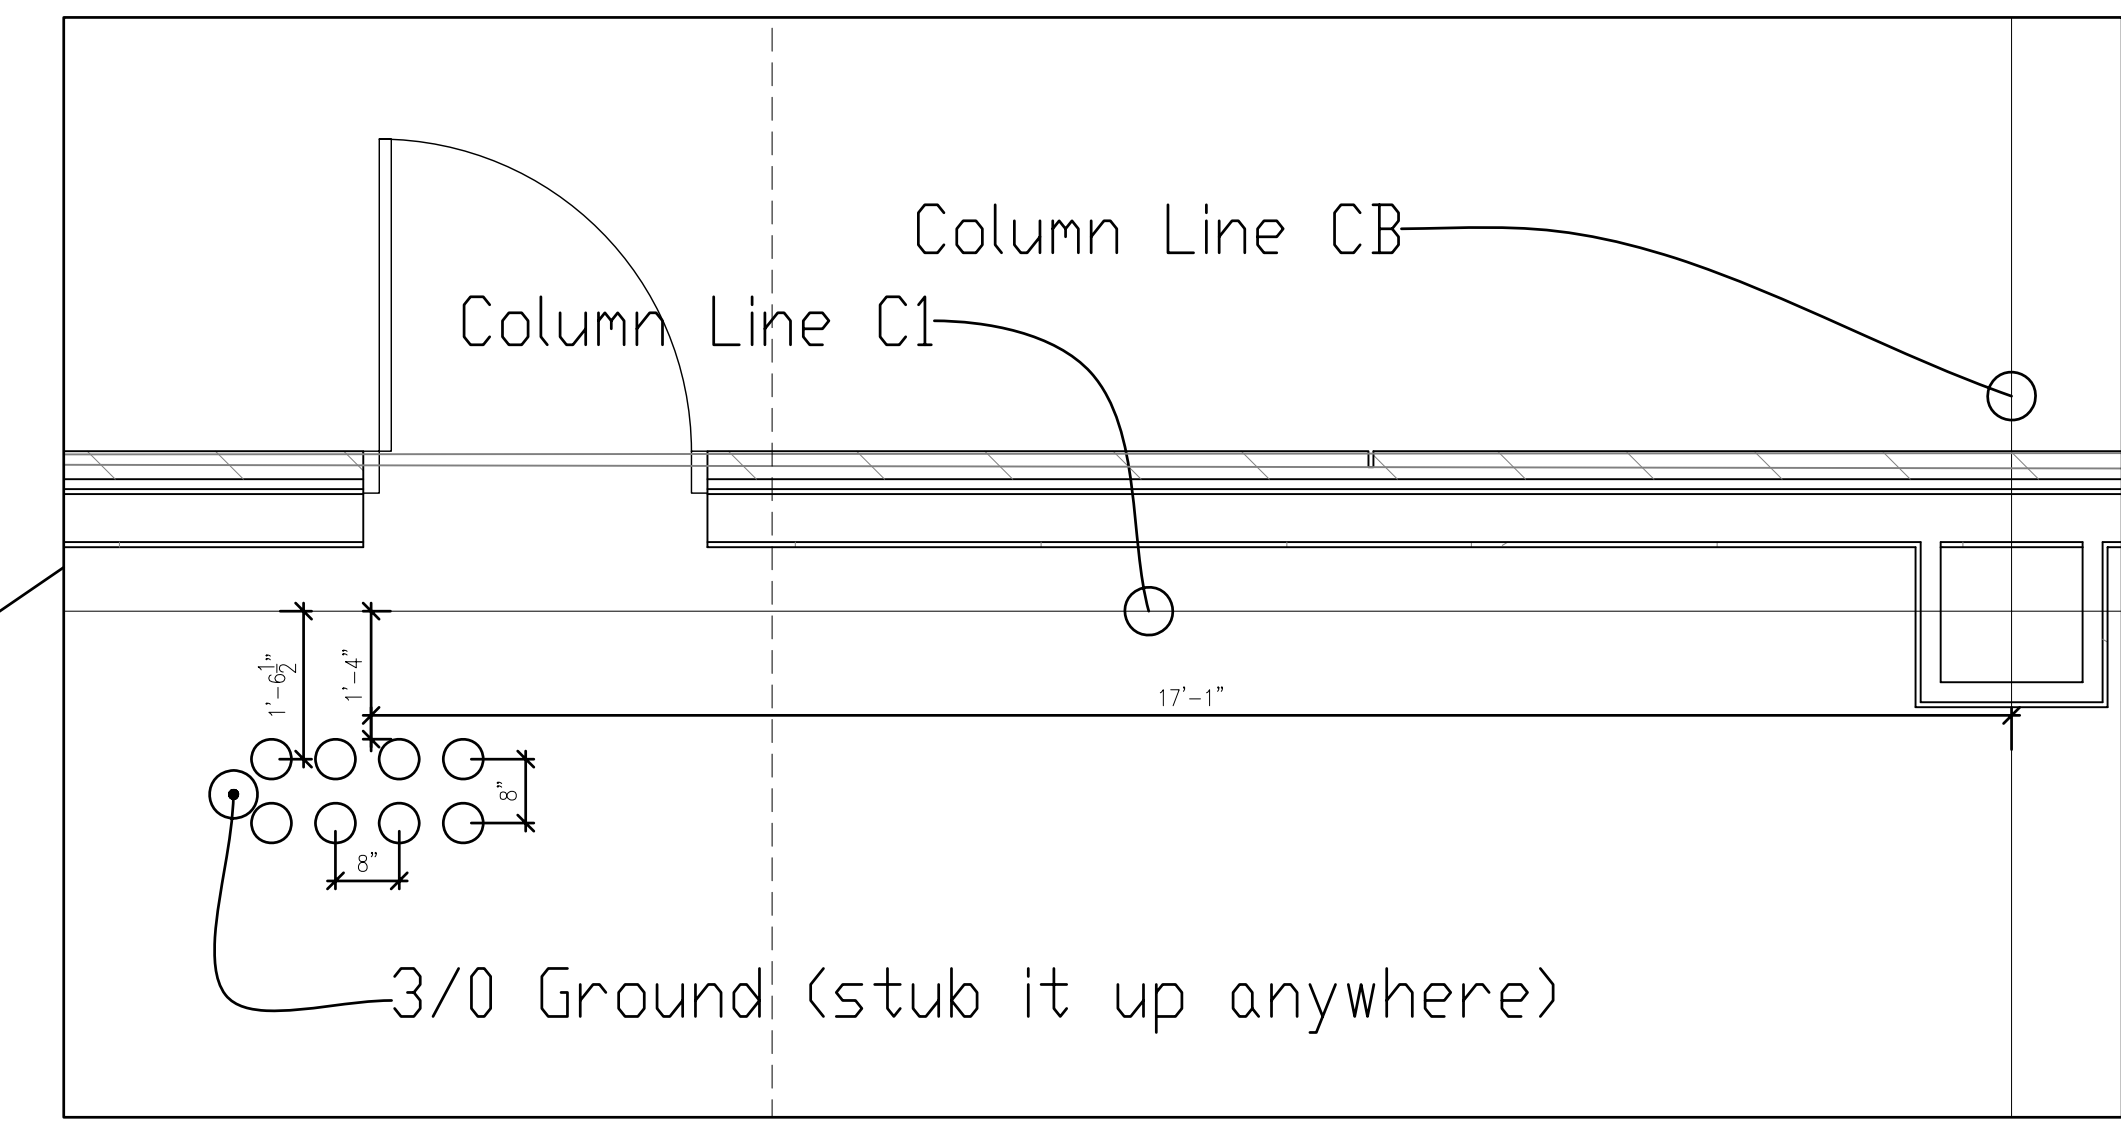

CSF Room 1811 Scale: 1"=4'

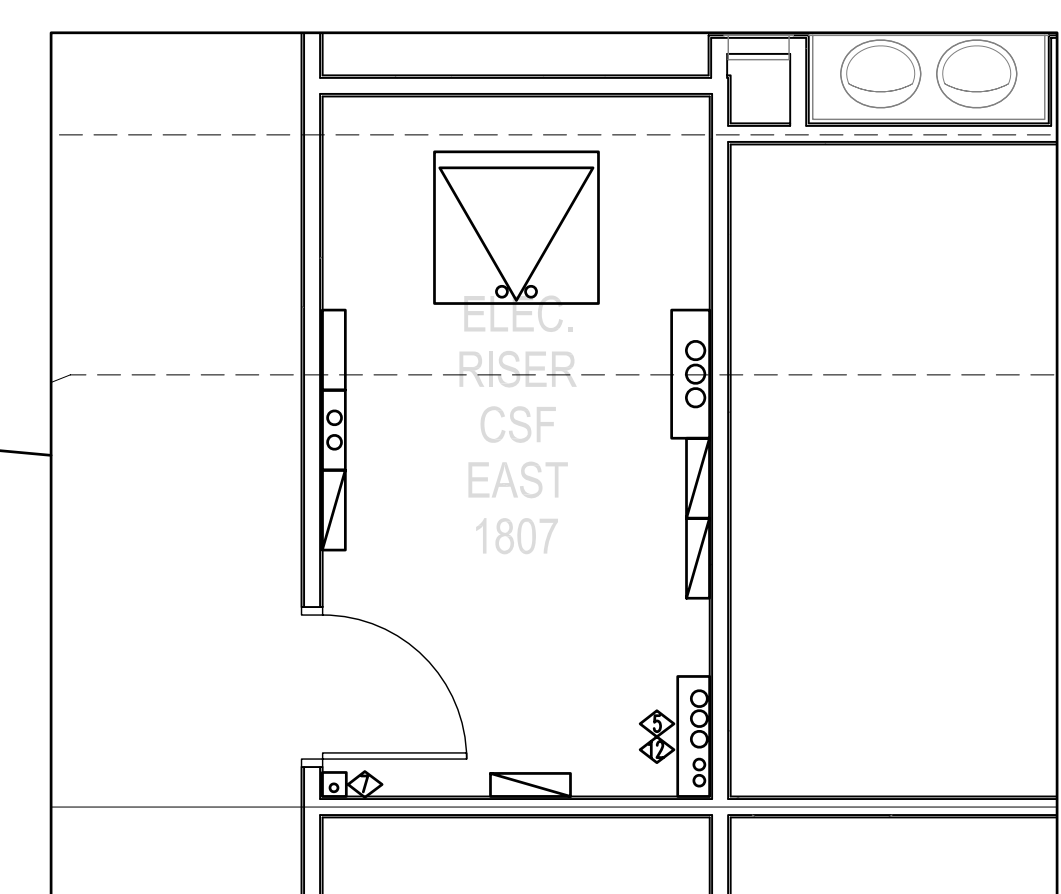

CSF Room 1807 Scale: 1"=4'

Note:
S-F-C = Sub Fed Panel Section

